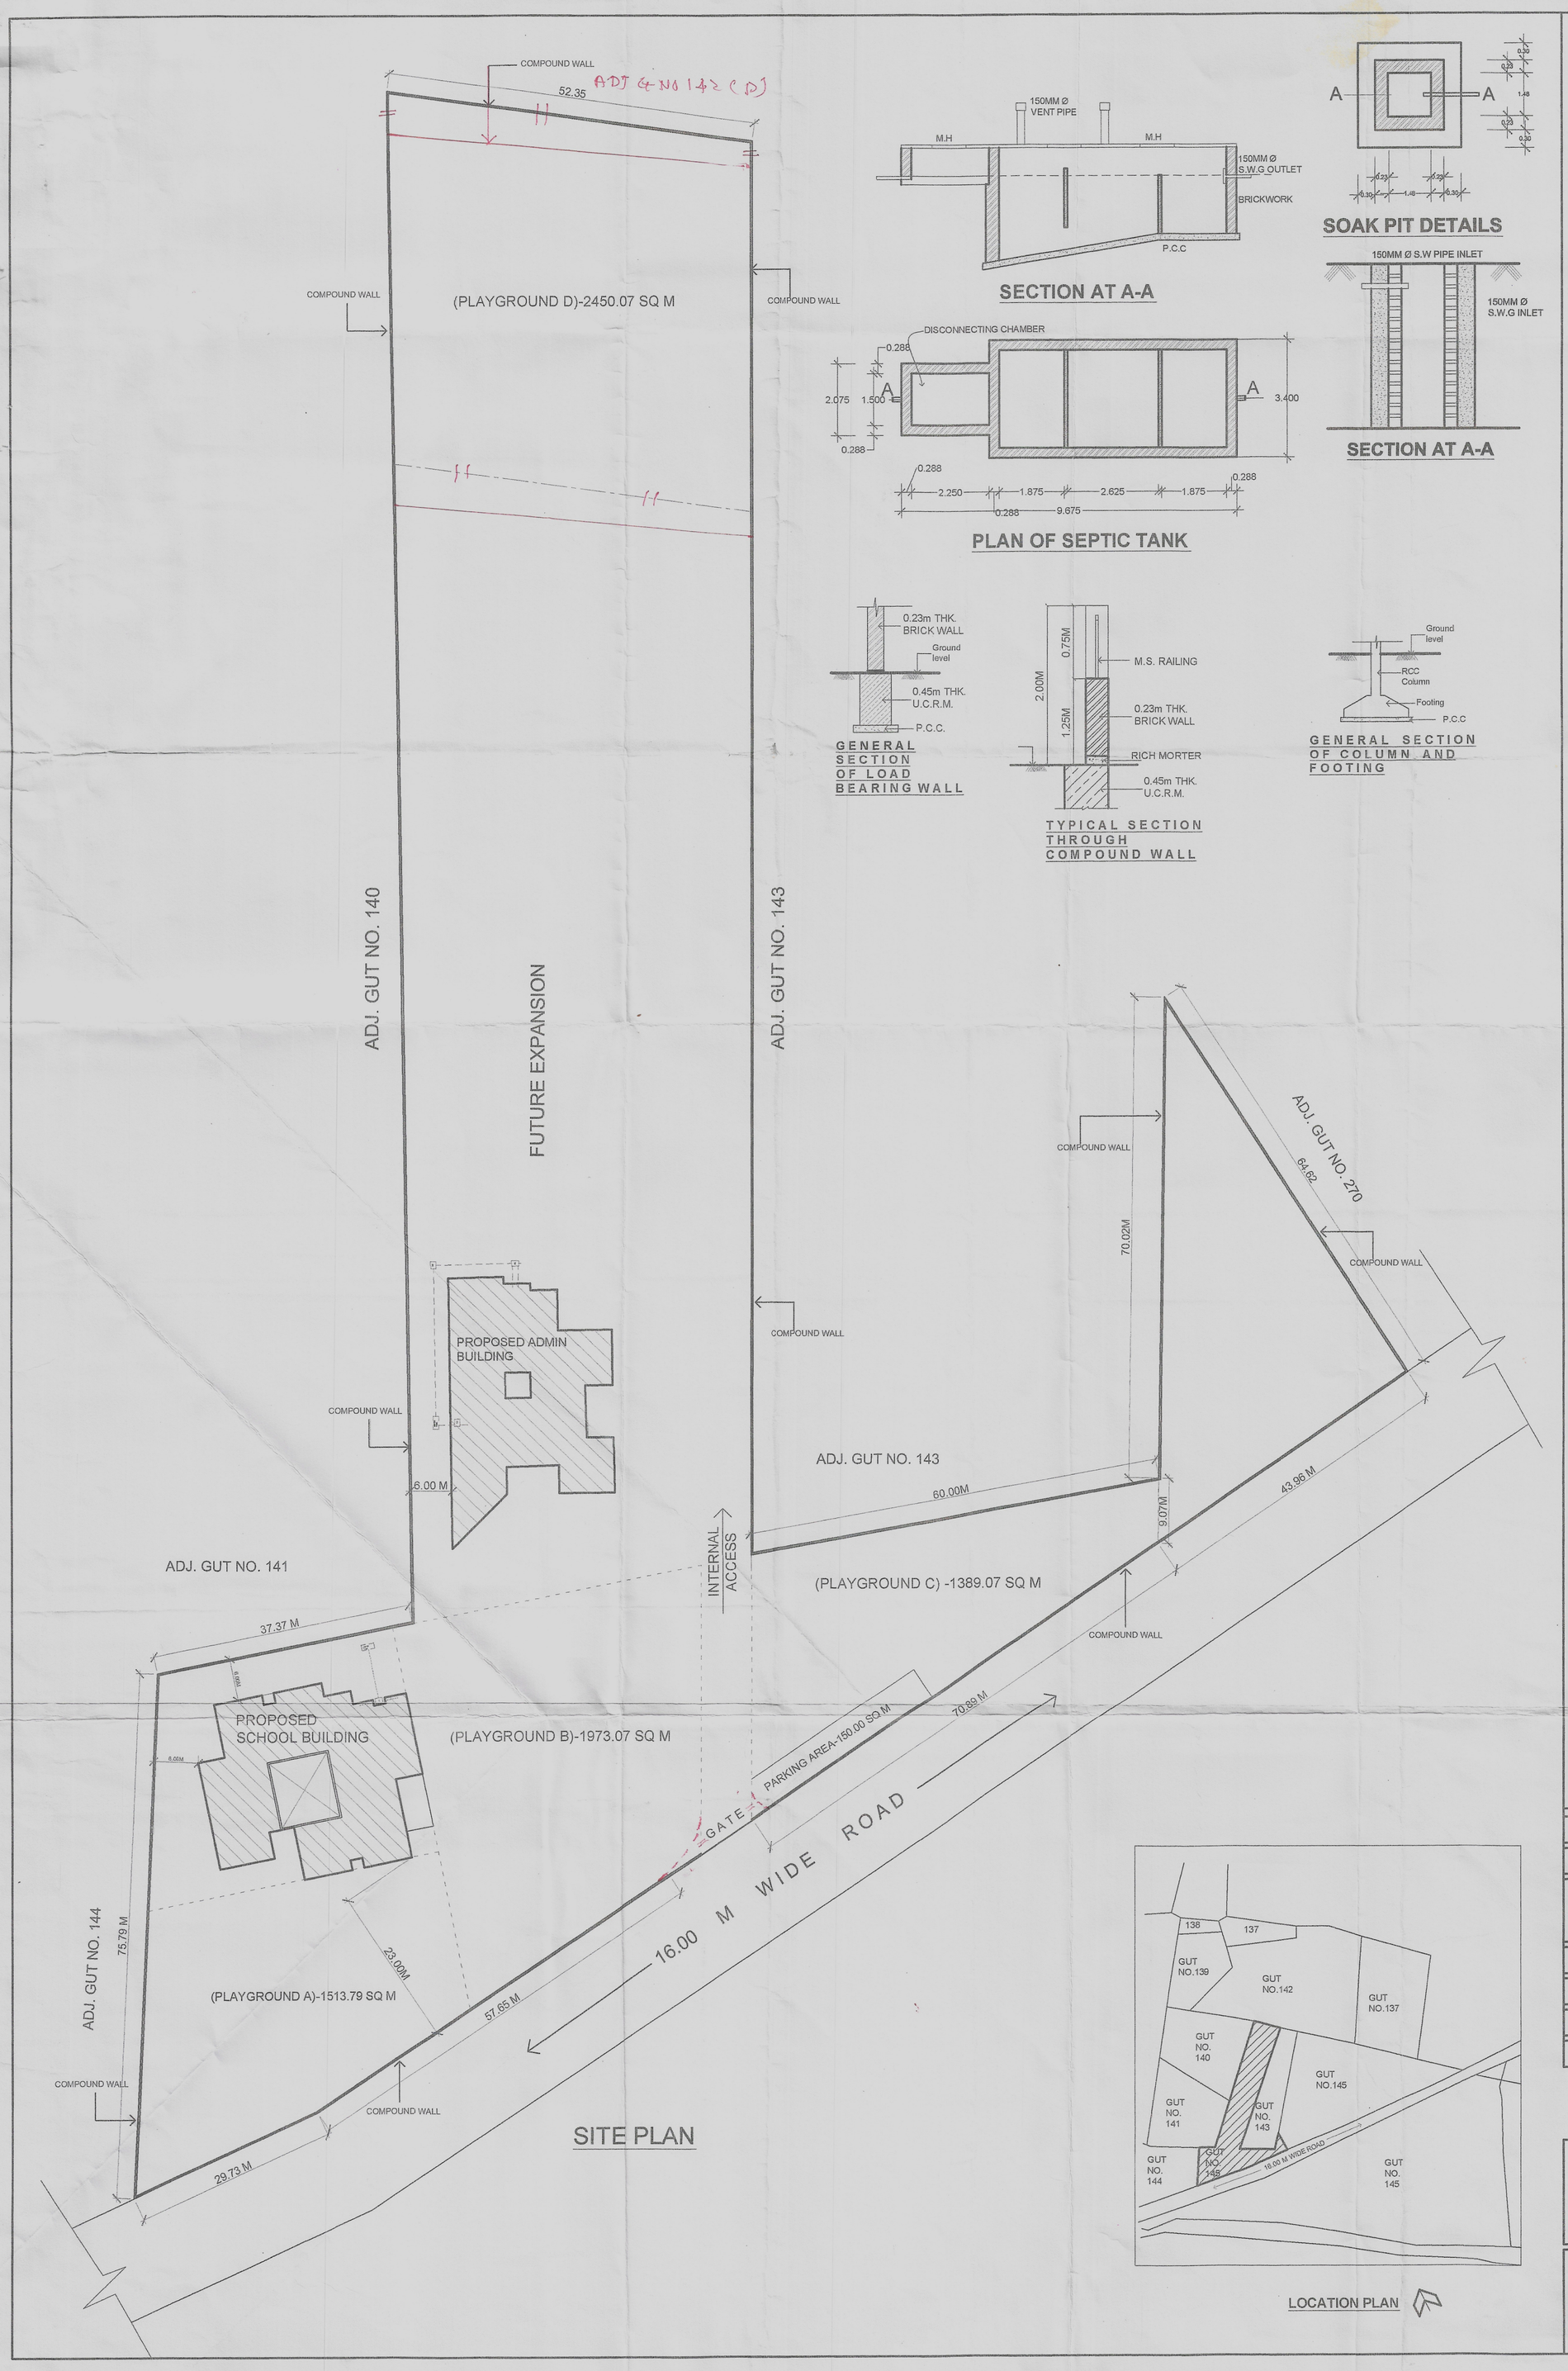


## AREA STATEMENT :-

| | | |
|---|---|---|
| 1) TOTAL AREA OF PLOT | = | 18200.00 sq.m. |
| 2) TOTAL AREA OF PLAYGROUND (40% OF PLOT AREA) | = | 7280.00 sq m |
| 3) PROVIDED PLAYGROUND AREA (A+B+C+D) | = | ~~7325.93~~ 7280.00 sq m |
| 4) PROPOSED BUILT UP AREA OF SCHOOL BUILDING | | |
| i) GROUND FLOOR | = | 422.38 sq.m. |
| ii) FIRST FLOOR | = | 604.54 sq.m. |
| TOTAL | = | 1026.92 sq.m. |
| 5) PROPOSED BUILT UP AREA OF ADMIN BUILDING | | |
| i) GROUND FLOOR | = | ~~653.07~~ 599.07 sq.m. |
| ii) FIRST FLOOR | = | 557.00 sq.m. |
| TOTAL | = | ~~1210.07~~ 1156.07 sq.m. |
| 6) TOTAL PROPOSED BUILT UP AREA (4+5) | = | ~~2236.99~~ 2182.99 sq.m. |
| 7) PROVIDED PARKING AREA | = | 150.00 sq.m. |

School (Education)
Recommended for Approval for
Purpose only as amended in.....
Subject to conditions mentioned in.
This office L. No. 7249 Dt. 22/3/2010

Town Planning & Valuation Department Maharashtra State JALGAON

Assistant Director of Town Planning, Jalgaon.

## NOTES :-

1) ALL EXTERNAL & INTERNAL WALLS ARE 0.23m & 0.115m THK. RESPECTIVELY.
2) ALL DIMENSIONS ARE IN METER.
3) PROPOSED STRUCTURE SHALL BE R.C.C. FRAME STRUCTURE.

## LEGEND :-

1) PLOT BOUNDRY SHOWN THUS
2) PROPOSED CONSTRUCTION SHOWN THUS
3) WATER LINE SHOWN THUS
4) SEWER LINE SHOWN THUS

| | | |
|---|---|---|
| DATE | REVISIONS | |
| CLIENT | UJJWAL EDUCTION TRUST | |
| TITLE OF THE PROJECT | THE PROPOSED SCHOOL CAMPUS ON GUT NO.145/1(A) & 142/2, AT SAVKHEDA , TQ. & DIST. JALGAON FOR UJJWAL EDUCATION TRUST | |
| DRAWN | VRUSHALI R. | CHECKED: SKM |
| SCALE | 1:500 | DATE : 05-04-10 |
| DRG. SPECIFICS | SUBMISSION DRAWING - SITE PLAN | |
| DRG. No. | UET/ARCH/S.D | |


**Nadkarni Mahajan & Associates**
ARCHITECTS, ENGINEERS, INTERIOR DESIGNERS, URBAN DESIGNERS
309,Akshaydeep Plaza, Town Centre, CIDCO,Jalna Road, Aurangabad 431003
Tel. : 2462731, 2483256 Fax : 0240 - 2481614, e mail : nmgroup@ sify .com


1/3

ARCHITECTS :

R. V. NADKARNI
B. Sc. B.Arch, F.I.I.A.
CA/83/7424

AR. S.K. Mahajan · S. K. MAHAJAN
B.Arch.,M.U.D.F.I.I.A.,C.A./85/9223 B.Arch, M.U.D, F.I.I.A.
CA/85/9223

OWNER:
UJJWAL EDUCTION TRUST
MRS.ANAGHA PRAVIN GAGDANI
MRS. MANASI PARIKSHIT PADADE